


EXAMPLE OF AN AS BUILT PLAN FOR DECK, PATIO AND LANDSCAPE REQUEST

Please show the exact location and dimensions of the proposed improvement on your plan.


**The following is an EXAMPLE of a submitted request for INFORMATIONAL PURPOSES only. No identifying information has been included. Please use your OWN information when submitting a request for ARB review. Submit online at: <https://applecrossarb.com>

THESE EXAMPLES CAN BE CHANGED AT ANY JUNCTURE AND IT IS THE RESPONSIBILITY OF THE HOME OWNER TO REFER TO THE LATEST RULES AND REGULATIONS PRIOR TO SUBMITTING AN ARB REQUEST.

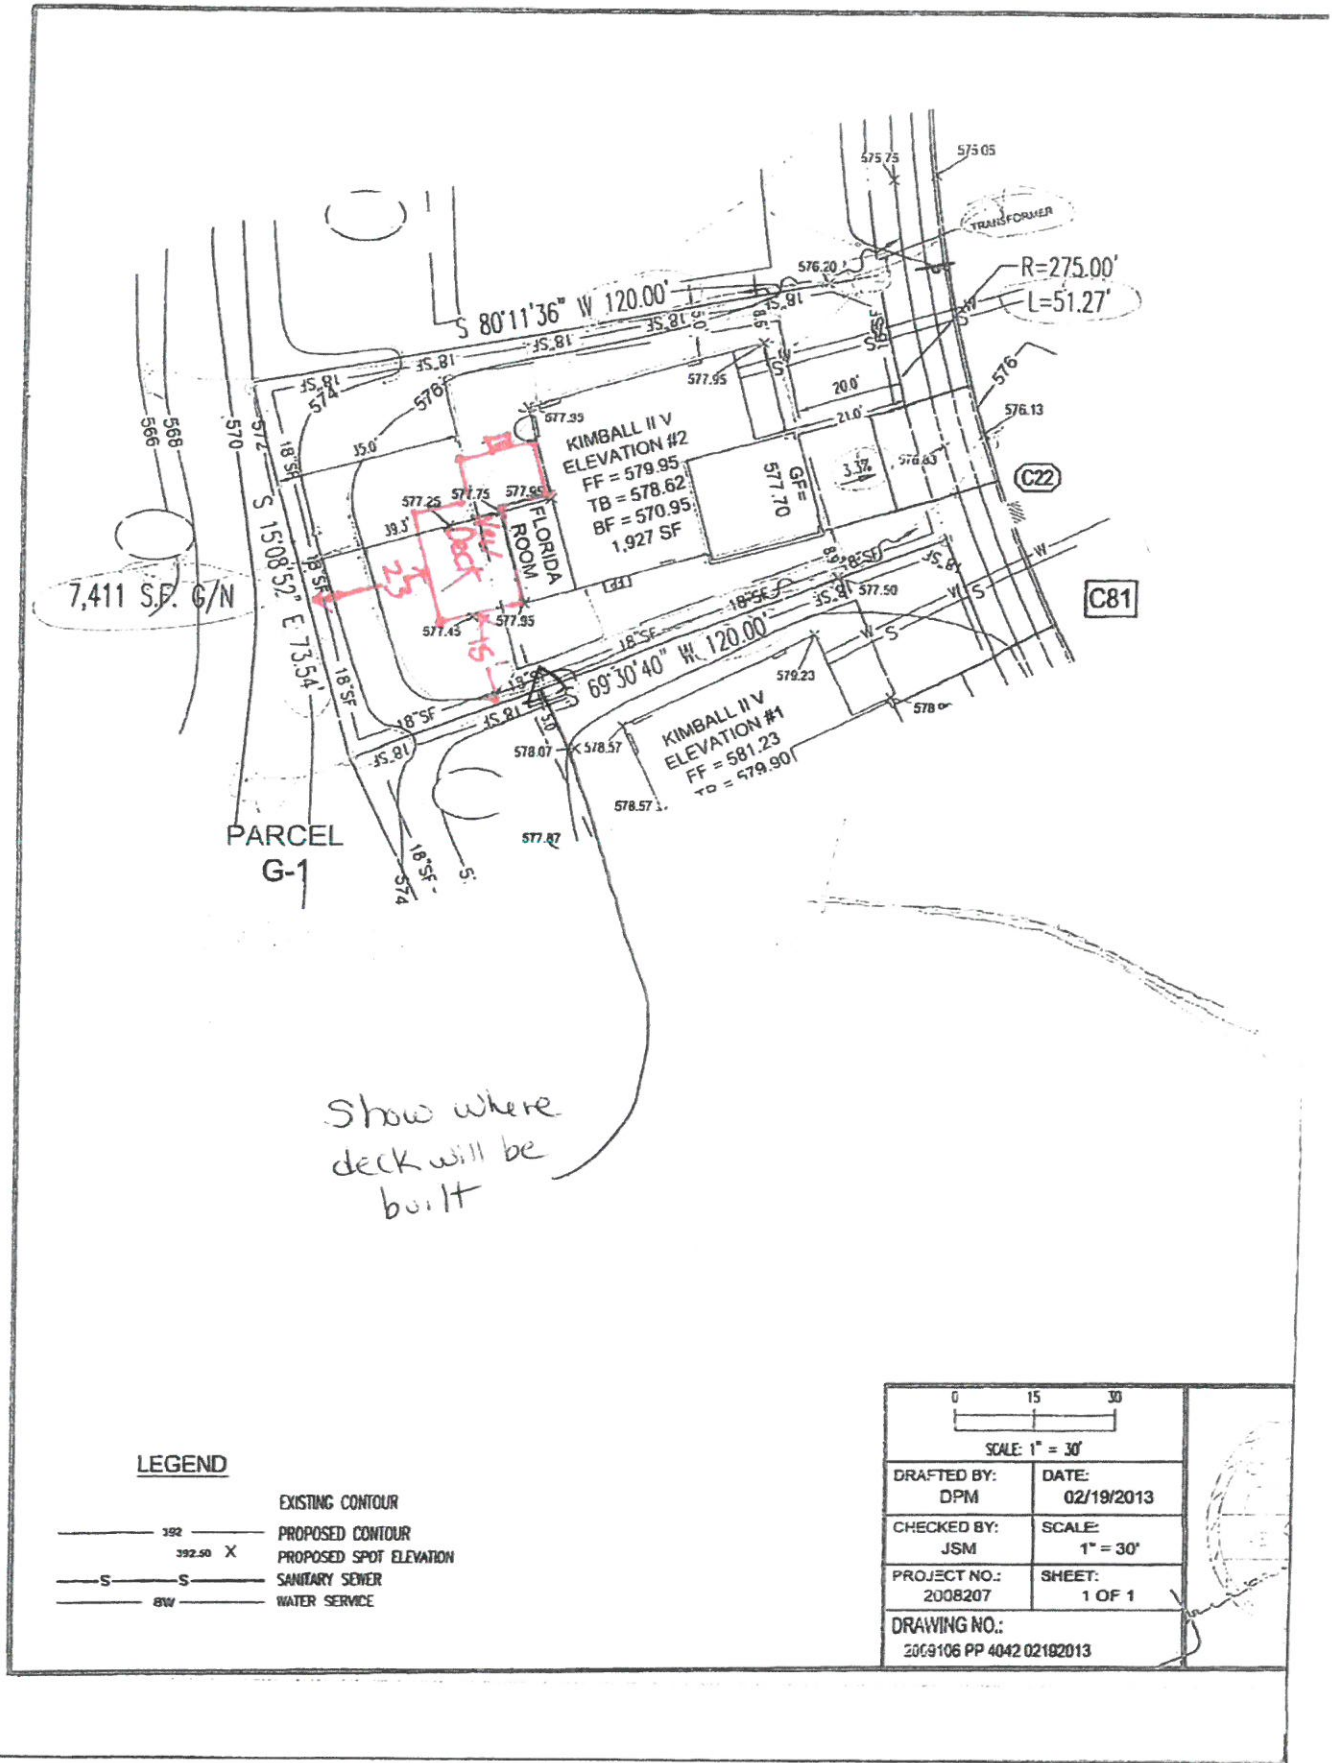

as built plan with improvement drawn on
DECK

Show where
patio will
be built

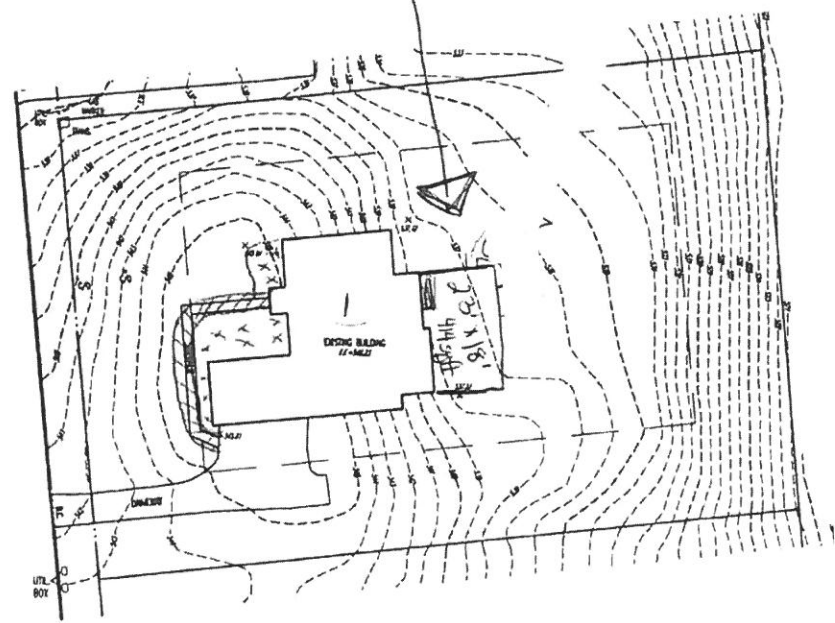


IMPERVIOUS COVERAGE		
LOT	31,219 S.F.	0.7167 AC.
BUILDING	2,779 S.F.	0.0638 AC.
DRIVEWAY & SIDEWALK	1,435 S.F.	0.0328 AC.

as built plan with improvement
drawn on

LOT 1 TOPOGRAPHIC AS-BUILT SURVEY

PREPARED FOR:
APPLECROSS
EAST BRANDYWINE TOWNSHIP, CHESTER COUNTY
COMMONWEALTH OF PENNSYLVANIA


PREPARED BY:
WILKINSON & ASSOCIATES, INC.
1220 VALLEY FORGE ROAD - THE COMMONS AT VALLEY FORGE
UNIT 25, P.O. BOX 987, VALLEY FORGE, PA 19482
PHONE (610) 415-1220 FAX (610) 415-1224

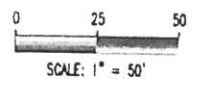

© 2013 WILKINSON & ASSOCIATES, INC.	DWG. NO.: 2008244AB-LOT-TOPO	DRAWN BY: CRS	DATE: 12/24/2013	SCALE: 1" = 50'
-------------------------------------	------------------------------	---------------	------------------	-----------------

PATIO


IMPERVIOUS COVERAGE		
LOT 10.43	6,174 S.F.	0.1417 AC.
BUILDING	1,193 S.F.	19.3%
DRIVEWAY & SIDEWALK	470 S.F.	7.6%
LOT 10.44	3,377 S.F.	0.0775 AC.
BUILDING	1,198 S.F.	35.5%
DRIVEWAY & SIDEWALK	486 S.F.	14.7%
LOT 10.45	5,908 S.F.	0.1356 AC.
BUILDING	1,205 S.F.	20.4%
DRIVEWAY & SIDEWALK	737 S.F.	12.5%

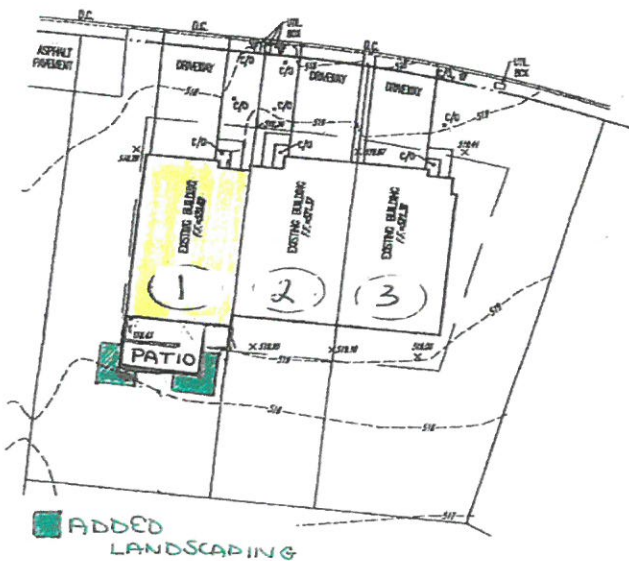

LOTS 1 THRU 3 TOPOGRAPHIC AS-BUILT

PREPARED FOR: **PULTE HOMES OF PA**
APPLECROSS COUNTRY CLUB
EAST BRANDYWINE TWP., CHESTER CO., PA

PREPARED BY: **WILKINSON & ASSOCIATES, INC.**
 1220 VALLEY FORGE ROAD - THE COMMONS AT VALLEY FORGE 1150 GLENHURST DRIVE, SUITE 33
 UNIT 25, P.O. BOX 987, VALLEY FORGE, PA 19482 ALLENTOWN, PA 18106
 PHONE (610) 415-1220 FAX (610) 415-1224 PHONE (610) 395-7940 FAX (610) 395-7999

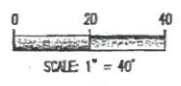

© 2014 WILKINSON & ASSOCIATES, INC. DWG. NO.: Z009170AB-FND DRAWN BY: CRS DATE: 10/21/2014 SCALE: 1" = 40'

as built plan with improvement drawn on
LANDSCAPE